


MISCELLANEOUS NOTES:

1. ONLY COPIES FROM THE ORIGINAL MAP MARKED WITH AN ORIGINAL LAND SURVEYOR'S EMBOSSED SEAL SHALL BE CONSIDERED VALID.
2. SIGNATURE AND EMBOSSED SEAL SIGNIFY THAT THIS MAP WAS PREPARED IN ACCORDANCE WITH THE PRACTICE CODE OF ETHICS ADOPTED BY THE N.J. STATE BOARD OF SURVEYING AND GEODYSY. THE PERSON FOR WHOM THE SURVEY IS INDICATED HEREON SHALL RUN ONLY TO THE PERSON FOR WHOM THE SURVEY IS MADE UNLESS OTHERWISE SPECIFIED BY THE SURVEYOR'S EMBOSSED SEAL.
3. UNAUTHORIZED ALTERATION OR ADDITION TO A SURVEY MAP BEARING A LICENSED LAND SURVEYOR'S SEAL IS ILLEGAL AND PUNISHABLE BY LAW.
4. PROPERTY IS SUBJECT TO DOCUMENTS OF RECORD.
5. BY CONTRACTUAL ARRANGEMENT, THIS SURVEY HAS BEEN PERFORMED AND PREPARED WITHOUT THE BENEFIT OF A TITLE POLICY.
6. OBJECTS SHOWN HEREON ARE NOT TO BE USED AS A BASIS FOR THE ESTABLISHMENT OF BOUNDARY LINES.
7. THIS SURVEY SHALL NOT BE UTILIZED OR INCORPORATED AS DOCUMENTATION FOR THE PURPOSES OF EXERCISING AND/OR EXERCISING A SURVEY AFFIDAVIT AND/OR AFFIDAVIT OF TITLE.
8. WETLANDS DEPICTED ON THIS PLAN TAKEN FROM PRIOR APPROVED WETLANDS DELINEATION MAPS PREPARED BY SONOCH DEPAWLA.
9. UTILITIES SHOWN HEREON ARE FROM OBSERVED EVIDENCE OF ABOVE GROUND UTILITIES AND ARE NOT TO BE USED TO ESTABLISH BOUNDARY LINES. THE PRESENCE OF UTILITIES IS NOT GUARANTEED AND SURVEYOR'S INVESTIGATION IS LIMITED TO VISUAL INSPECTION AND SURFACE INVESTIGATIONS.

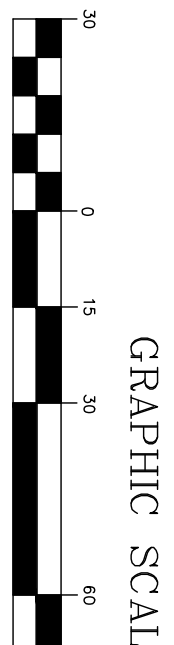

NOTICE

THIS PLAN AND ALL INFORMATION CONTAINED HEREON ARE THE PROPERTY OF DAS ENGINEERS - SURVEYORS - PLANNERS - ENVIRONMENTALISTS, LLC. NO PART OF THIS PLAN OR INFORMATION CONTAINED HEREON MAY BE REPRODUCED, COPIED, OR TRANSMITTED IN ANY FORM OR BY ANY MEANS, ELECTRONIC OR MECHANICAL, INCLUDING PHOTOCOPYING, RECORDING, OR BY ANY INFORMATION STORAGE AND RETRIEVAL SYSTEM, WITHOUT THE WRITTEN PERMISSION OF DAS ENGINEERS - SURVEYORS - PLANNERS - ENVIRONMENTALISTS, LLC.

| DATE | REVISION | BY | APPROVED |
|----------|-------------------------------|-----|----------|
| 1/14/19 | ADDED EASEMENT RECORDING DATA | GMV | |
| 10/21/19 | REVISED PER TOWN COMMENTS | GMV | |
| 10/8/19 | UPDATE PLAN TO DATE | GMV | |

DAS
ENGINEERS - SURVEYORS - PLANNERS - ENVIRONMENTALISTS

DAVID A. STILES ASSOCIATES, LLC
ENGINEERS - SURVEYORS - PLANNERS - ENVIRONMENTALISTS

678 US HWY 202/206 N. SUITE 6
HUNTERDON/TOWNSHIP, N.J. 08807
PHONE: (908)252-7000 FAX: (908)252-7000

GARY V. ARMCO
PROFESSIONAL LAND SURVEYOR
N.J. LICENSE NO. 37999
DATE: 1/29/19

DESIGNED BY:
DRAWN BY: SMT
CHECKED BY: DAS

AS-BUILT PLAN
ANSUYA RIVERBEND, LLC
TAX BLOCK 17 LOT 2
TOWN OF CLINTON, HUNTERDON COUNTY, NEW JERSEY

PROJECT NO. 06065
SHEET NUMBER 2 OF 2

SYMBOL LEGEND:

| | |
|---|-----------------|
| N | North |
| S | South |
| E | East |
| W | West |
| ○ | Spot |
| □ | Temporary Box |
| ○ | Survey Control |
| ○ | Survey Station |
| ○ | Type A Stake |
| ○ | Type B Stake |
| ○ | Type C Stake |
| ○ | Hydrant |
| ○ | Water Meter |
| ○ | Ground Light |
| ○ | Shed Light |
| ○ | Light |
| ○ | Monitoring Well |
| ○ | Open Well |
| ○ | Checkered Well |
| ○ | Right of Way |
| ○ | Centerline |